


REVIEWED AND ACCEPTED
LAKE COUNTY GENERAL
HEALTH DISTRICT

Date: 6/28/00
By: Harold B. Morris

SEWAGE DISPOSAL PERMIT MUST BE
OBTAINED BY A LAKE COUNTY LICENSED
INSTALLER BEFORE INSTALLATION IS
STARTED.

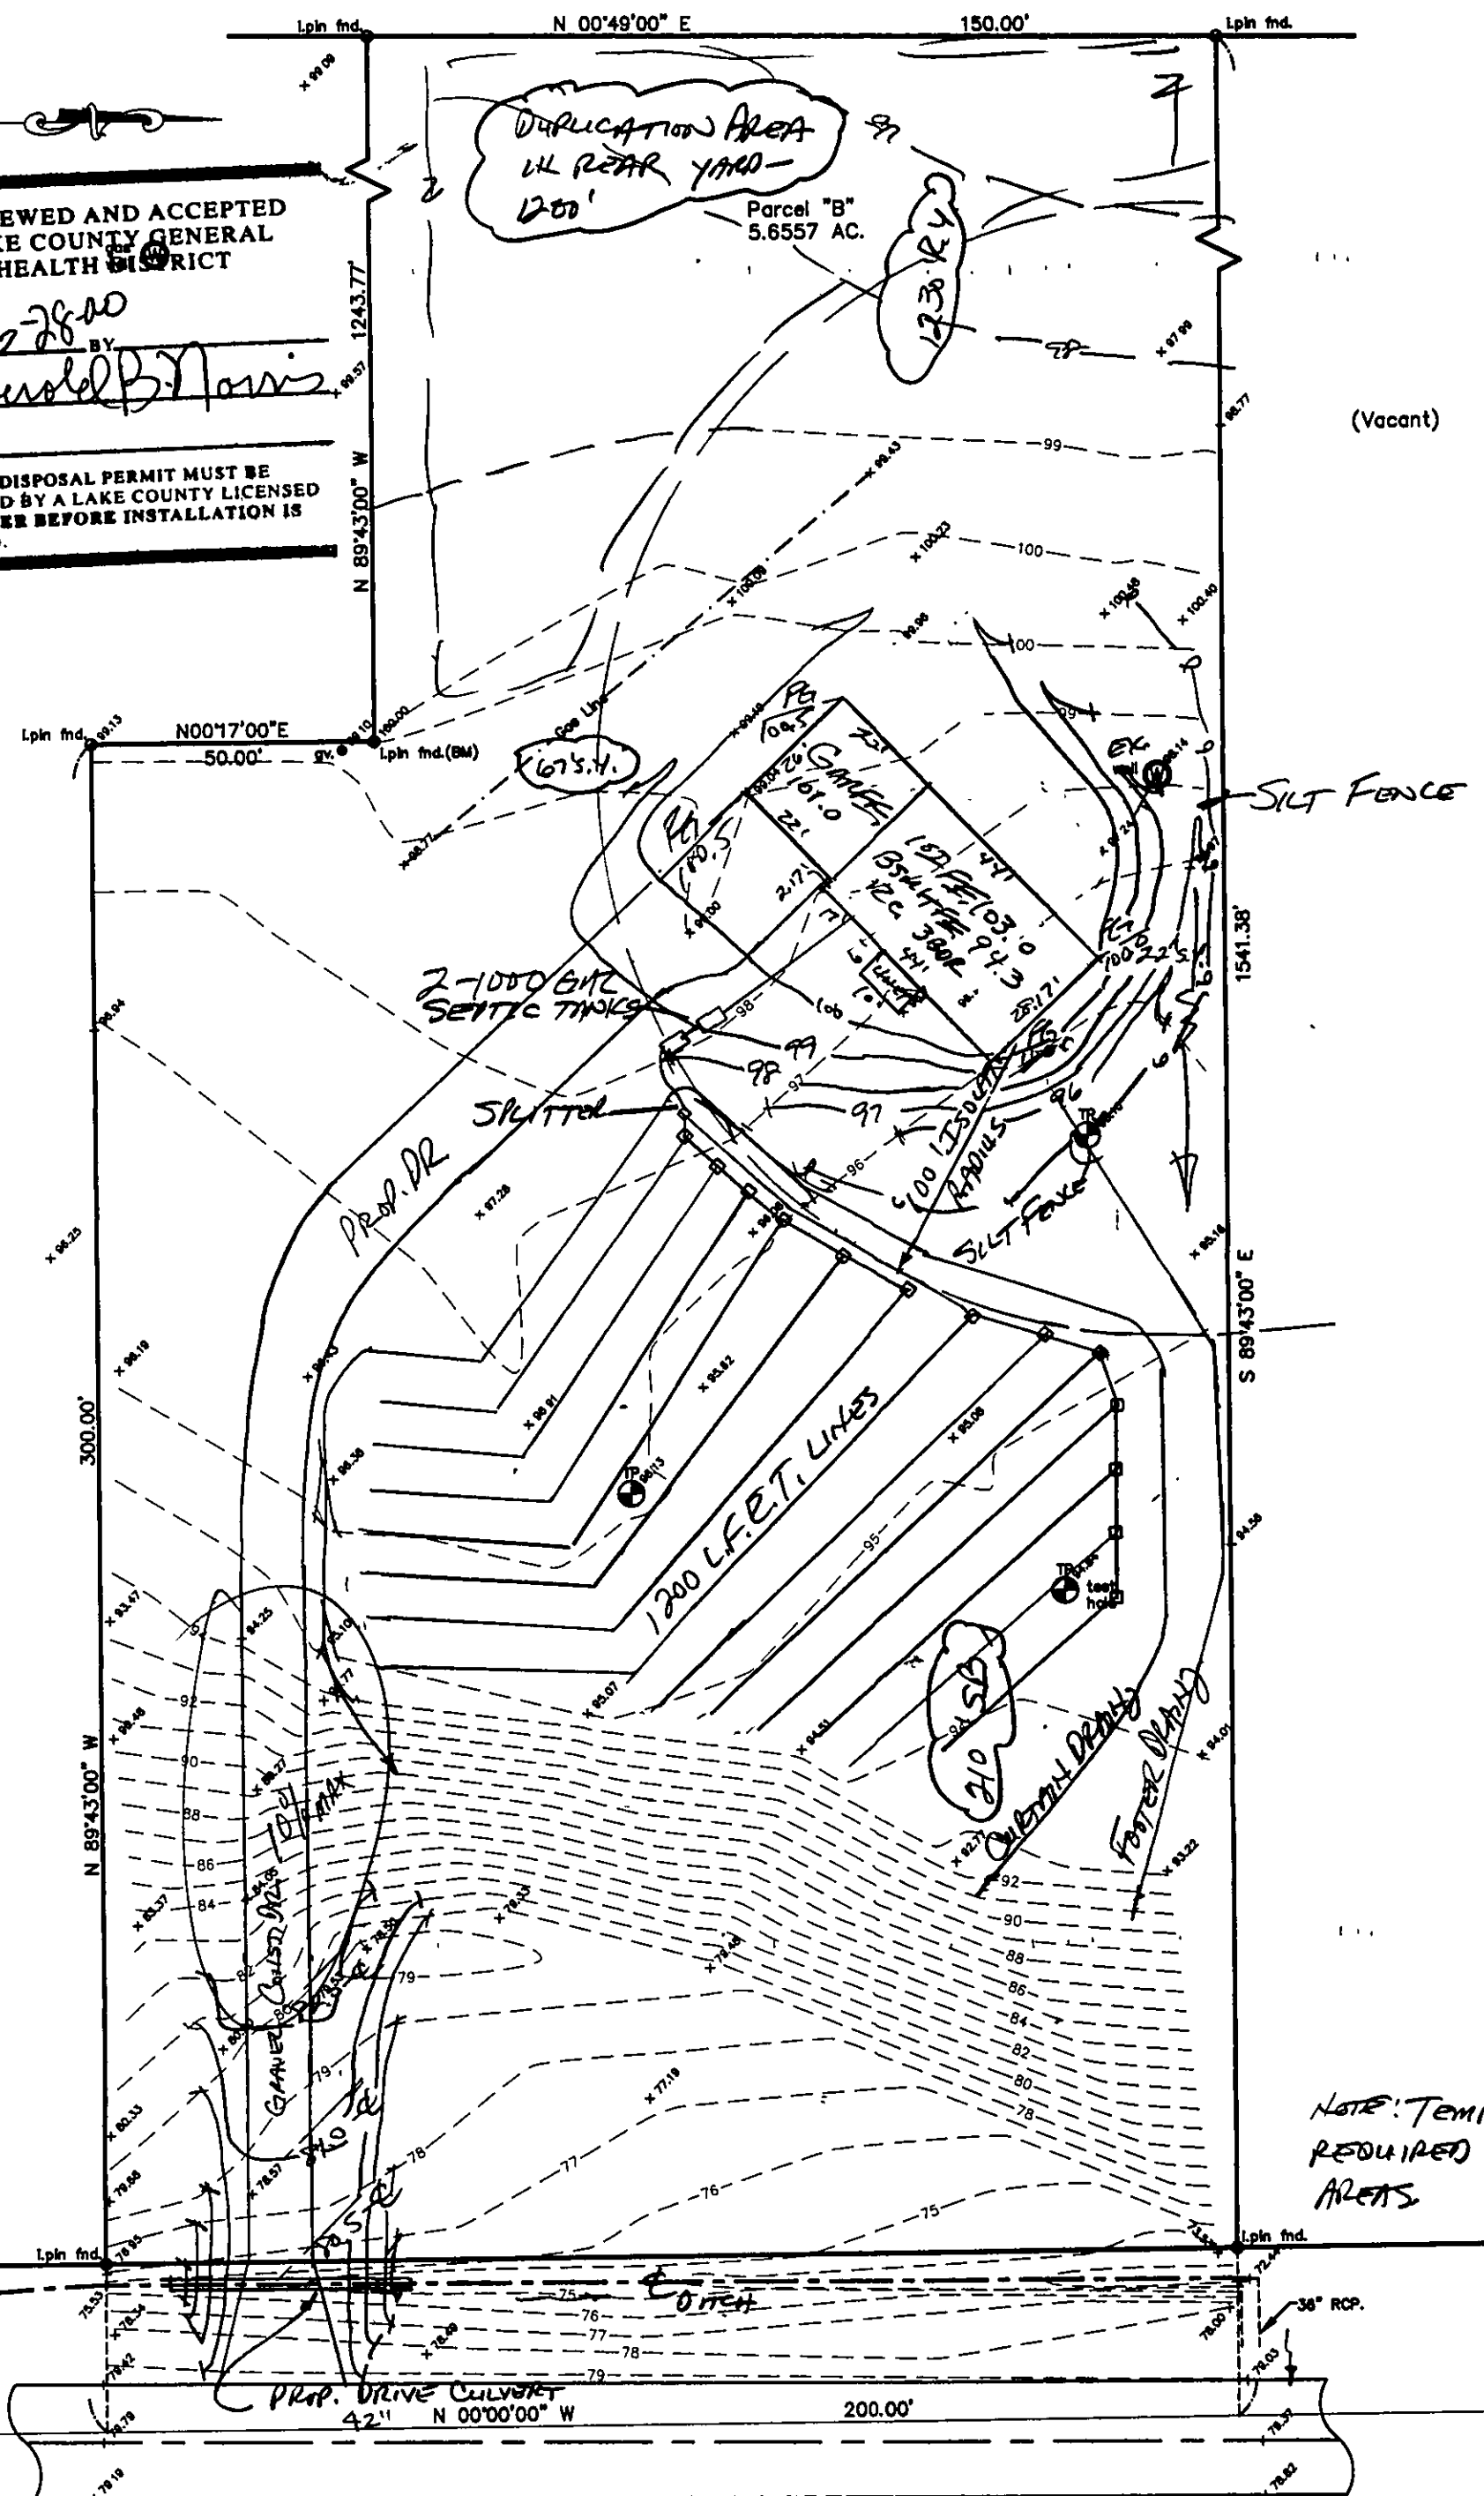

SITE PLAN

LERoy TOWNSHIP, LAKE COUNTY, OHIO
for: MARK GRIEBEL

CLIENT: MARK GRIEBEL
OWNER: MARK GRIEBEL
ADDRESS: PAINESVILLE, OHIO
SUBDIVISION: PAINESVILLE, OHIO
NAME: PAINESVILLE, OHIO
TRACT: PAINESVILLE, OHIO
LOT: PAINESVILLE, OHIO
VOL.-PG.: PAINESVILLE, OHIO
SUBLOT NO.: PAINESVILLE, OHIO
STREET: PAINESVILLE, OHIO
VOL.-PG.: PAINESVILLE, OHIO
PERM. PARCEL NO.: PAINESVILLE, OHIO

LEGEND

SANITARY MANHOLE: 100.0 EXIST. ELEV. 100.0 100.0 100.0 PROP. ELEV.
STORM MANHOLE: 100.0 EXIST. ELEV. 100.0 100.0 100.0 PROP. ELEV.
INLET OR CATCH BASIN: 100.0 EXIST. ELEV. 100.0 100.0 100.0 PROP. ELEV.
HYDRANT: 100.0 EXIST. ELEV. 100.0 100.0 100.0 PROP. ELEV.
EXISTING CONTOURS: 100.0 EXIST. ELEV. 100.0 100.0 100.0 PROP. ELEV.
PROPOSED CONTOURS: 100.0 EXIST. ELEV. 100.0 100.0 100.0 PROP. ELEV.

REMARKS

ALL BOUNDARY DATA SHOWN WAS OBTAINED FROM (DEEDS, RECORDED
SUBDIVISION PLAT OR OTHER PUBLIC RECORDS)
LOCATIONS AS SHOWN OF ADJACENT WELLS AND SEPTIC TANKS OBTAINED FROM
LAKE COUNTY HEALTH DEPARTMENT

DESIGN CERTIFICATION

THIS PLAT WAS PREPARED BY ME, AND IS CORRECT
TO THE BEST OF MY KNOWLEDGE AND BELIEF.

CHECK LIST

NO. OF BEDROOMS: 1
DIMENSIONS: 100' x 100'
BEARINGS: N 00° 49' 00" E
TIE TO NEAREST STREET: 150.00'
SUBLOT NO. PARCEL NO.: 12345
SURROUNDING OWNERS: 12345
BLDG. DIMENSIONS FIN GR.: 100' x 100'
BLDG. TIES FL'R. GRADES: 100' x 100'
APRON TYPE WIDTH THICKNESS: 100' x 100'
SIDEWALK TYPE WIDTH THICKNESS: 100' x 100'
CULVERT TYPE DIA. LENGTH: 100' x 100'
ROCK OUTCROPPINGS: 100' x 100'
WATER MAIN SIZE, LOCATION: 100' x 100'
SAN. SEWER SIZE & GR. LOC.: 100' x 100'
SAN. MH. CAST. ELEV. INV. ELEV.: 100' x 100'
SAN. CONN. SIZE, LOC. DEPTH: 100' x 100'
STORM SEWER SIZE & GR. LOC.: 100' x 100'
STORM MH. CAST. ELEV. INV. ELEV.: 100' x 100'
PAV'T TYPE GRADE CURBS: 100' x 100'
GAS LINE LOC. SIZE PRESSURE: 100' x 100'
SEPTIC TANK LOCATION & DUPLICATION AREA: 100' x 100'
WELL LOCATION: 100' x 100'
ISOLATION RADIUS FROM WELL: 100' x 100'

REVISIONS			PLAN PREPARED BY:		
NO.	DATE	BY	NAME	DATE	REGISTRATION NO.
1	6/21/00	HT	T.R.	6/18/00	440-357-1811
2	6/27/00	HT	H.J.	6/18/00	00-147
3	7/21/00	HT	W.B.	6/18/00	00-147
4					
5					

"AS BUILT" CERTIFICATION
I, HEREBY CERTIFY THAT THE CIRCLED GRADES ARE EXISTING
FINISH GRADES CHECKED IN THE FIELD ON 6/18/00, 20
AND ARE CORRECT TO THE BEST OF MY KNOWLEDGE AND BELIEF.

REGISTERED SURVEYOR: TBM - TOP OF IRON PIN
ELEV. = 100.00

TBM - TOP OF IRON PIN
ELEV. = 100.00


NOTE: TEMPORARY SEEDING
REQUIRED IN DISTURBED
AREAS.

Grading Plan Approved
as shown and/or noted
THOMAS P. GILLES, P.E.
Lake County Engineer

By: TBM Date: 8/3/00
MAX. GRADE FOR DIVE 10' 10'

"I, the undersigned hereby certify that
this topography indicated by 6", 1", or 2"
contours, and elevations shown hereon
represent an actual field survey made by
me on the 17th day of JULY, 2000
and that the elevations were taken at
appropriate intervals and that as of that
date they existed as indicated hereon."

Ref. Leroy Twp.
Zoning 2709

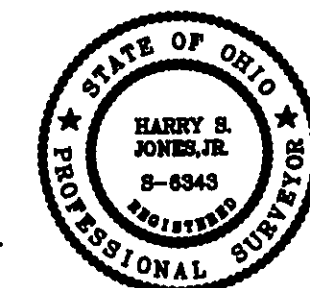

Name: Harry S. Jones, Jr. #6343
Reg. No.:

PAINE ROAD - 60'